

PROPOSAL

M. A. Y. Construction Company, Inc.
 P.O. Box 1025
 Franklin, TN 37065
 Office/Fax: 615.791.9877

PROPOSAL NO.	002949
SHEET NO.	
DATE	10-9-15

PROPOSAL SUBMITTED TO: Kevin

WORK TO BE PERFORMED AT:

NAME	CITY OF Franklin - Parks Dept
ADDRESS	705 Boyd Mill Ave Franklin, TN. 37064
PHONE NO.	615-794-2103

ADDRESS	HARLINSDALE FARMS
CONCRETE WORK.	
DATE OF PLANS	
ARCHITECT	

We hereby propose to furnish the materials and perform the labor necessary for the completion of

- (1) DIRT Removal & haul OFF AS NEEDED Per Depth.
- (2) STONE - Place Approx 4" of Stone For BASE. $\frac{3}{4}$
- (3) BOLLARDS - PLACE 12 BOLLARDS @ Designated AREAS. Dig ADDITIONAL 2' in Depth & 2' x 2' Footing. Pour CONCRETE Around BOLLARDS & INSIDE BOLLARD For Extra Strength. Schedule 40 Steel BOLLARD.
- (4) PLACE 1 pipe, guardrail etc From BANK to FENCE AS DISCUSSED.
- (5) CONCRETE - Pour Approx 2,320 sq. Ft. of 4000 PSI @ 8" in Depth with FIBER MESH.
- (6) REBAR - PLACE NO 4 on 5 BAR on 1' center throughout.

All material is guaranteed to be as specified, and the above work to be performed in accordance with the drawings and specifications submitted for above work and completed in a substantial workmanlike manner for the sum of THIRTY NINE THOUSAND, EIGHT HUNDRED AND EIGHTY Dollars (\$ 39,880.00) with payments to be made as follows. upon completion & approval

Respectfully submitted

Per M.A.Y. Const. Co. Inc.

Any alteration or deviation from above specifications involving extra costs will be executed only upon written order, and will become an extra charge over and above the estimate. All agreements contingent upon strikes, accidents or delays beyond our control.

Note — This proposal may be withdrawn by us if not accepted within 30 days.

ACCEPTANCE OF PROPOSAL

The above prices, specifications and conditions are satisfactory and are hereby accepted. You are authorized to do the work as specified. Payments will be made as outlined above.

Signature: _____


Date: _____

Signature: _____

PROPOSAL

Trash collection/recycle and manure containment center

COF Operations Dashboard

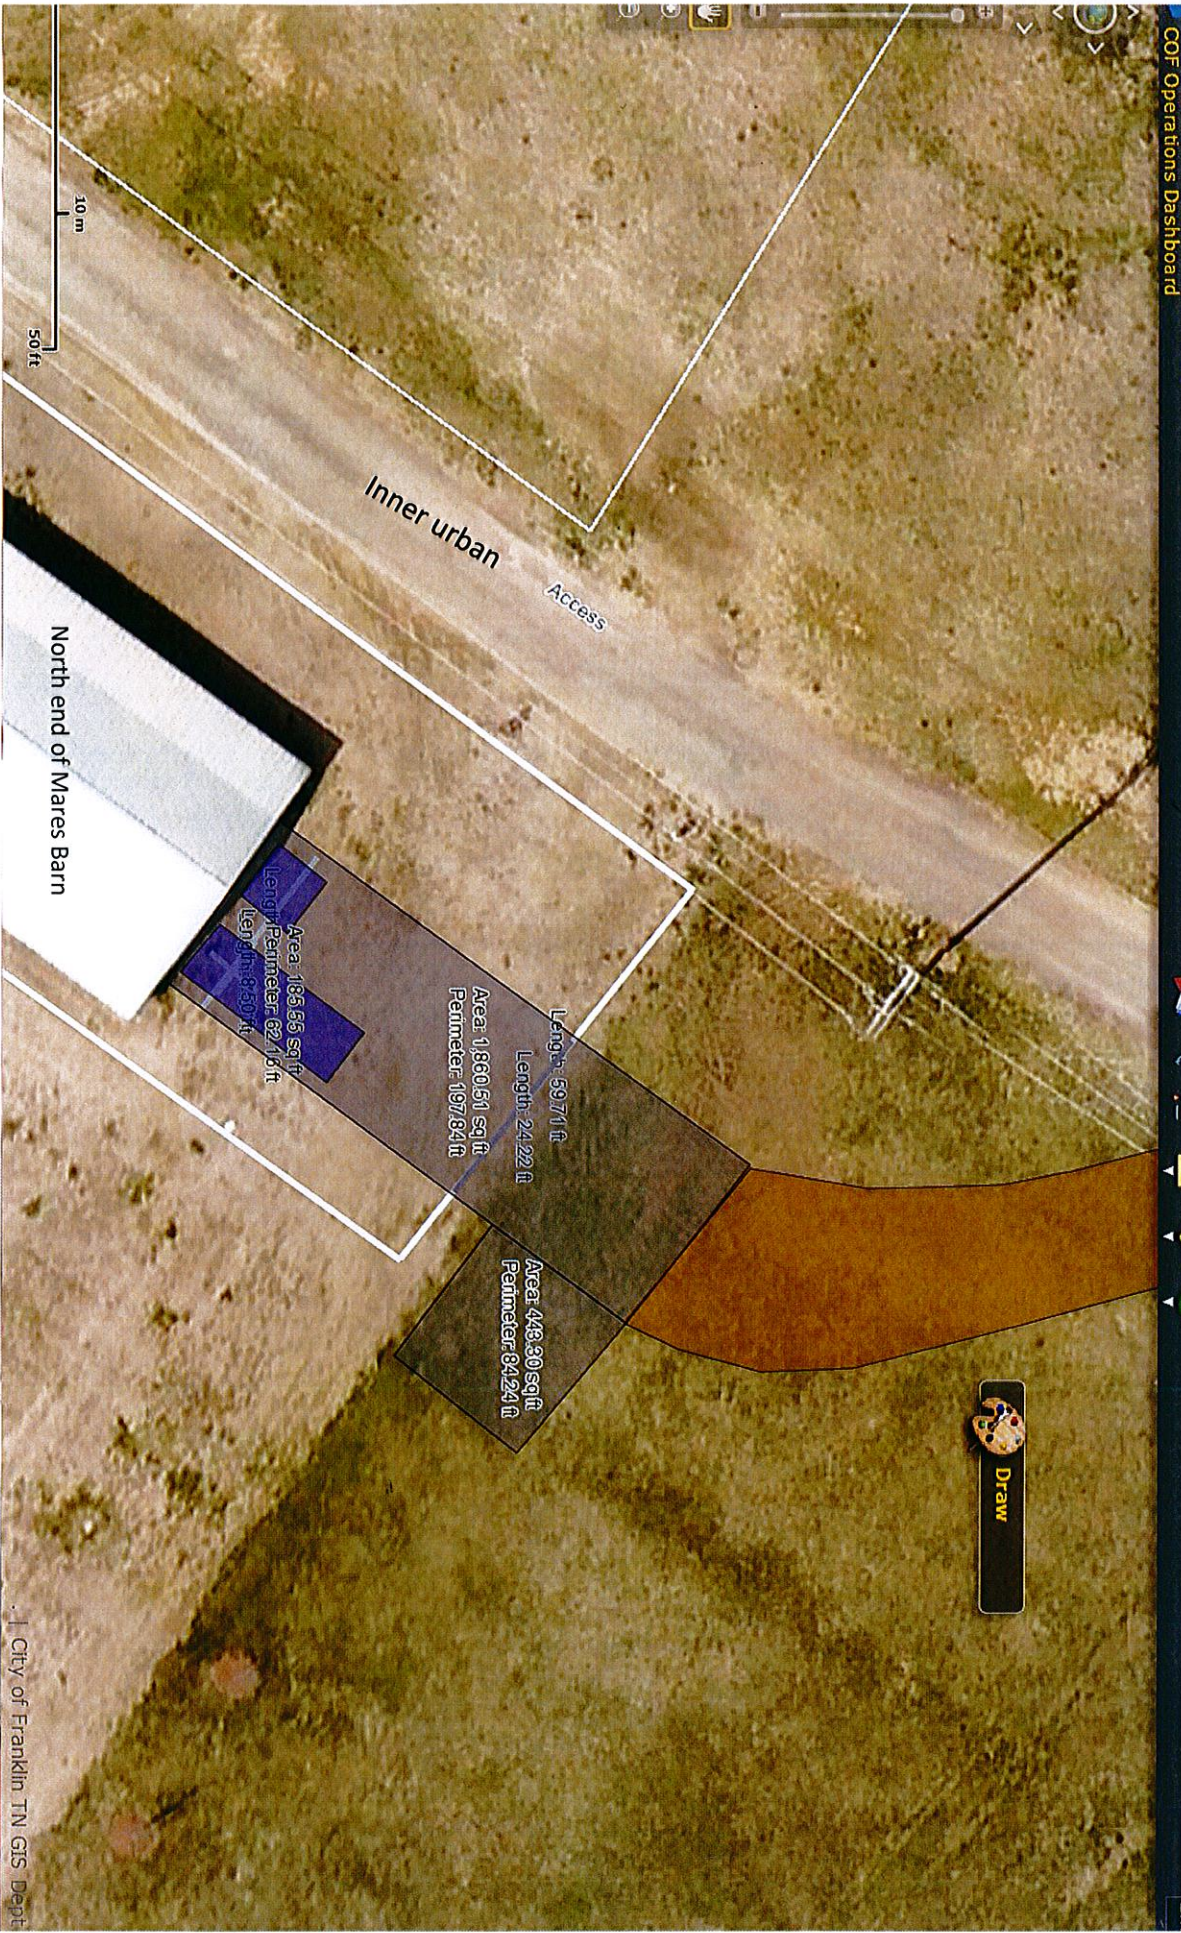

Tan is west to mix

Grey is concrete

Blue is dumpsters

Plan
Under Roof Square Footage

Ticketing Barn
1,020.00

Plan Cost Analysis		Current Quarter			pct.change	sqft.
Account	Name	budget	rev.budget	var.		
143-0020	Design/Plan Serv			-	#DIV/0!	0.00
143-0025	Interior Design			-	#DIV/0!	0.00
143-0040	Closing Cost			-	#DIV/0!	0.00
143-0041	Loan Fees			-	#DIV/0!	0.00
143-0042	Title Fees			-	#DIV/0!	0.00
143-0043	Record&Transfer			-	#DIV/0!	0.00
143-0160	Warranty Fees			-	#DIV/0!	0.00
143-0170	HBA Assess.			-	#DIV/0!	0.00
143-0200	Loan Interest			-	#DIV/0!	0.00
143-0252	No Start			-	#DIV/0!	0.00
143-0254	Development Tax			-	#DIV/0!	0.00
143-0255	Impact Fee			-	#DIV/0!	0.00
143-0260	Building Permit	1,614.00	-	1,614.00	100.00%	1.58
143-0265	Gas Tap Fee			-	#DIV/0!	0.00
143-0270	Water Tap Fee	1,500.00	-	1,500.00	100.00%	1.47
143-0280	Sewer Tap Fee			-	#DIV/0!	0.00
143-0281	HOA Fee			-	#DIV/0!	0.00
143-0305	Reproduction Plans	325.00	325.00	-	0.00%	0.32
143-0410	Temp Electric	577.00	577.00	-	0.00%	0.57
143-0420	Temp Water	115.00	115.00	-	0.00%	0.11
143-0430	Gas Connect Fee			-	#DIV/0!	0.00
143-0440	Electric Connect	275.00	275.00	-	0.00%	0.27
143-0600	Temp Toilet	340.00	340.00	-	0.00%	0.33
143-0701	RE Taxes			-	#DIV/0!	0.00
143-0703	Appraisal Fees			-	#DIV/0!	0.00
143-0800	Builders Risk	485.00	485.00	-	0.00%	0.48
143-1053	Surveys	1,400.00	-	1,400.00	100.00%	1.37
143-1163	Clear/Site Prep	1,200.00	-	1,200.00	100.00%	1.18
143-1173	Rough Grade	800.00	-	800.00	100.00%	0.78
143-1183	Erosion	821.50	-	821.50	100.00%	0.81
143-1301	Labor Footings			-	#DIV/0!	0.00
143-1302	Materials Footings			-	#DIV/0!	0.00
143-1401	Labor Foundation			-	#DIV/0!	0.00
143-1402	Materials Foundation			-	#DIV/0!	0.00
143-1501	Labor Waterproofing			-	#DIV/0!	0.00
143-1502	Materials Waterproof			-	#DIV/0!	0.00
143-1553	Back Fill			-	#DIV/0!	0.00
143-1653	Termite	140.00	140.00	-	0.00%	0.14
143-1701	Labor - Slab	11,068.72	25,736.08	(14,667.36)	-132.51%	10.85
143-1702	Materials Slab			-	#DIV/0!	0.00
143-2101	Frame Labor	13,770.00	13,770.00	-	0.00%	13.50
143-2102	Frame Mat.	26,094.90	37,616.25	(11,521.35)	-44.15%	25.58
143-2402	Windows			-	#DIV/0!	0.00
143-2441	Weatherstrip		7,896.97	(7,896.97)	#DIV/0!	0.00
143-2442	Ext.Doors	1,092.77	10,136.81	(9,044.04)	-827.63%	1.07
143-2563	Metal Roofing	12,598.77	16,279.19	(3,680.42)		12.35
143-2571	Roof Materials			-	#DIV/0!	0.00
143-2571	Roof Labor			-	#DIV/0!	0.00
143-2582	Flashing/Louvers	3,396.05	3,396.05	(0.00)	0.00%	3.33
143-2610	Shutters	1,786.00	1,786.00	(1,786.00)	#DIV/0!	0.00
143-2651	Brick Labor			-	#DIV/0!	0.00
143-2652	Brick Materials			-	#DIV/0!	0.00
143-2653	Sand			-	#DIV/0!	0.00
143-2702	Stone Materials			-	#DIV/0!	0.00
143-2753	Stucco			-	#DIV/0!	0.00
143-2803	Clean Brick			-	#DIV/0!	0.00
143-2853	Garage Doors			-	#DIV/0!	0.00
143-3053	Plumbing	7,975.00	17,500.00	(9,525.00)	-119.44%	7.82
143-3103	HVAC	5,925.00	7,500.00	(1,575.00)	0.00%	5.81
143-3152	Electric Materials	6,862.50	14,431.25	(7,568.75)	0.00%	6.73
143-3153	Electric	1,332.00	-	1,332.00	100.00%	1.31
143-3453	Fireplace			-	#DIV/0!	0.00
143-3552	Sewer/Water Mat.	407.63	1,019.08	(611.45)	-150.00%	0.40
143-3553	Sewer/Water Install	1,586.00	1,586.00	-	0.00%	1.55
143-3561	Labor - Grinder Pump			-	#DIV/0!	0.00
143-3562	Mat - Grinder Pump			-	#DIV/0!	0.00
143-4103	Insulation	3,138.50	3,206.96	(68.46)	-2.18%	3.08
143-4201	Drywall Labor	2,812.00	3,515.00	(703.00)	-25.00%	2.76
143-4202	Drywall Materials	2,183.05	2,183.05	-	0.00%	2.14
143-4573	Cabinets & Tops	1,190.40	5,420.00	(4,229.60)	-355.31%	1.17
143-4643	Counter tops			-	#DIV/0!	0.00
143-4701	Int.Trim Labor	2,105.00	3,683.75	(1,578.75)	-75.00%	2.06
143-4702	Int.Trim Materials	1,796.96	5,317.73	(3,520.77)	-195.93%	1.76
143-4711	Mantles			-	#DIV/0!	0.00
143-4712	Specialty Trim			-	#DIV/0!	0.00
143-4713	Built Ins & Vanities			-	#DIV/0!	0.00
143-4722	Stair Parts			-	#DIV/0!	0.00
143-5172	Light Fixtures	1,091.33	3,843.29	(2,751.96)	-252.17%	1.07
143-5603	Paint	6,934.14	12,828.16	(5,894.02)	-85.00%	6.80
143-6052	Acrylic Tub Divrd			-	#DIV/0!	0.00
143-6053	Ceramic Tile	5,155.00	-	5,155.00	100.00%	5.05
143-6083	Cultured Marble	628.80	-	628.80	100.00%	0.62
143-6103	Hardwood			-	#DIV/0!	0.00
143-6203	Carpet			-	#DIV/0!	0.00
143-6303	Vinyl Flooring			-	#DIV/0!	0.00
143-6551	Labor Appliances			-	#DIV/0!	0.00
143-6552	Appliances	334.50	334.50	-	0.00%	0.33
143-6603	Bath Hardware	214.13	214.13	(0.00)	0.00%	0.21
143-6652	Hardware	825.00	825.00	-	0.00%	0.81
143-6703	Mirrors & Shower	3,876.59	8,874.23	(4,997.64)	-128.92%	3.80
143-6720	Specialty Bath			-	#DIV/0!	0.00
143-5230	Shelving			-	#DIV/0!	0.00
143-7401	Labor Flatwork			-	#DIV/0!	0.00
143-7402	Materials Flatwork			-	#DIV/0!	0.00
143-7403	Pavers & Curb			-	#DIV/0!	0.00
143-8251	Finish Grade	600.00	-	600.00	100.00%	0.59
143-8403	Landscape			-	#DIV/0!	0.00
143-8423	Irrigation			-	#DIV/0!	0.00
143-8453	Sod			-	#DIV/0!	0.00
143-8653	Pool			-	#DIV/0!	0.00
143-8870	Sub Iron Fence			-	#DIV/0!	0.00
143-8902	Address Marker	281.39	-	281.39	100.00%	0.28
143-8903	Signage			-	#DIV/0!	0.00
143-8950	Mailbox	425.00	-	425.00	100.00%	0.42
143-9013	Final Wash	300.00	300.00	-	0.00%	0.29
143-9021	Labor-Ext. Clean Up	2,960.00	2,960.00	-	0.00%	2.90
143-9031	Interior Clean	826.97	826.97	-	0.00%	0.81
143-9052	Materials Punch List	250.00	1,275.00	(1,025.00)	-410.00%	0.25
143-9053	Punch List	300.00	1,387.00	(1,087.00)	-362.33%	0.29
144-0211	Building Fee	30,000.00	32,685.82	(2,685.82)	-8.95%	29.41
Total Direct Cost		169,930.59	250,591.27	(80,660.68)	-47.47%	166.60
Percentage Change				(0.47)		

Notes

Review structural details

Add to go to pressure treated for FEMA
Bid mistake on Riverbirch from original - pricing is being revised
Increase due to metal doors, frames, hardware and fire rating - COF requirements
Estimate was 5V - now going to Standing Seam

Bid mistake on Riverbirch from original - pricing is being revised

Includes tankless hot water heater, pump and recirculating line - COF requirements
Originally bid for venting only
Add for equipment load not previously considered

Originally budgeted as plywood counters and cabinets, now being done in laminate
Increased scope and detail for plan compliance
Increased scope and detail for plan compliance

Original was only allowance - will look at VE and repricing
Original was builder grade flat paint - add is request for COF maintenance

ADA & misc material increases

Increased allowance
Increased allowance
Slight increase due to cost increases

CITY OF FRANKLIN
WATER and WASTEWATER SCHEDULE OF FEES
 Effective January 1, 2012 (Ordinance 2011-29)

Meter Size	WATER				IRRIGATION			RECLAIMED		SEWER and METERED SEWER				
	ACCESS FEE	CONNECTION (TAP FEE)			Irrigation Meter (Plus Install)	CONNECTION (TAP FEE)		CONNECTION (TAP FEE)		ACCESS FEE	EFFLUENT DISPOSAL FEE	CONNECTION (TAP FEE)		
		SDF	Installation of meter & box			Installation of meter & box		Installation of meter & box				SDF	Installation Fee	
			System Development Fee	Tap Already Made		Tap Not Made	Tap Already Made	Tap Not Made	Connection Fee				Installation	System Development Fee
3/4"	\$1,186.00	\$903.00	\$315.00	\$756.00	\$3,150.00	\$315.00	\$756.00	\$500.00	\$720.00	\$2,100.00	\$450.00	\$1,444.00	\$263.00	\$1,240.00
1"	\$4,746.00	\$3,612.00	\$374.00	\$897.00	\$4,725.00	\$374.00	\$897.00	\$500.00	\$853.50	\$8,400.00	\$1,800.00	\$5,775.00	\$263.00	\$1,240.00
1.5"	\$11,390.00	\$8,619.00	\$656.00	\$1,444.00	\$6,300.00	\$656.00	\$1,444.00	\$500.00	\$1,375.00	\$20,160.00	\$4,320.00	\$13,860.00	\$263.00	\$1,240.00
2"	\$15,187.00	\$11,558.00	\$1,362.00	\$2,223.00	\$7,875.00	\$1,362.00	\$2,223.00	\$500.00	\$2,116.50	\$26,880.00	\$5,760.00	\$18,480.00	\$263.00	\$1,240.00
3"	\$33,222.00	\$25,284.00	\$1,581.00	\$3,654.00	\$9,450.00	\$1,581.00	\$3,654.00	\$500.00	\$3,480.00	\$58,800.00	\$12,600.00	\$40,425.00	\$263.00	\$1,240.00
4"	\$47,460.00	\$36,120.00	\$2,668.00	\$5,492.00	\$11,025.00	\$2,668.00	\$5,492.00	\$500.00	\$5,230.00	\$84,000.00	\$18,000.00	\$57,750.00	\$263.00	\$1,240.00
6"	\$113,904.00	\$86,688.00	\$4,723.00	\$7,387.00	\$12,600.00	\$4,723.00	\$7,387.00	\$500.00	\$7,035.00	\$201,600.00	\$43,200.00	\$138,600.00	\$263.00	\$1,240.00
8"	\$142,380.00	\$108,360.00	\$10,293.00	\$14,110.00	\$14,175.00	\$10,293.00	\$14,110.00	\$500.00	\$13,438.00	\$252,000.00	\$54,000.00	\$173,250.00	\$263.00	\$1,240.00

FOR GUIDELINE USAGE ONLY; SHOULD THERE BE DIFFERENCES WITH THE MUNICIPAL CODE, THEN TITLE 22 CHAPTER 18 SHALL PREVAIL

Hi-flow/low flow will be the next meter size up for pricing purposes - Ex: 2 inch domestic meter and 8 inch fire line, the price will be for a 3" meter plus the \$500.00 per inch for the fire line.

All fees must be paid at REVENUE MANAGEMENT prior to construction of water and/or sewer facilities or issuance of a building permit, depending on the type of development.

Residential Development - Access fees, inspection fees and plan review fees shall be paid prior to the issuance of a construction permit for the installation of water and/or sewer facilities. System development fees and installation fees shall be paid prior to issuance of a building permit.

Commercial Development - Inspection fees and plan review fees shall be paid prior to the issuance of a construction permit for the installation of water and/or sewer facilities. System development fees, access fees, installation fees and any other applicable fees shall be paid prior to issuance of a building permit.

PLAN REVIEW FEE - These are paid when plans are submitted and is \$300 each for water (irrigation included in water if at availability requested at same time as water), sewer & reclaimed.

INSPECTION FEE(s) - These apply for water, irrigation & reclaimed (\$1.25/lf, \$1,000 min) and sewer (\$2.00/lf-gravity; \$1.50/lf-force w/\$1,000 min); these are paid for new construction.

INITIAL SERVICE FEE (18-103) - There is a \$25.00 fee when tap fees are paid for new construction for each account or delivery point (parcel, lot, meter).

APPLICATION FEE (18-103) - There is a \$50.00 fee when establishing service for each account or delivery point (parcel, lot, meter). This fee does not apply when water is provided by the city.

ACCESS FEE - A charge for the privilege of connecting to the water or sewer system and is in addition to the SDF. Funds are used to provide additional funds for additions, replacements & repairs. Calculated at \$1,186 per SFU for WATER and \$2,100 per SFU for SANITARY SEWER.

CONNECTION FEE - These are typically paid by the builder prior to issuance of the building permit and include the costs associated with lot connections.

SYSTEM DEVELOPMENT FEE - A fee to be paid by any person or entity making a connection to the water or sewer system of the COF, which charge is made for the purpose of enabling the city to provide service.

INSTALLATION FEE - A charge to be paid the COF for the purpose of reimbursing the city for its expenses, including labor & materials, for installing a service line from the main (water, sewer, or reclaimed).

EFFLUENT DISPOSAL FEE (EDA) - The effluent disposal assessment (EDA) fee is for the disposal of treated wastewater to repair, replace and expand its reclaimed water facilities, as needed. The EDA is based on the size of the water or reclaimed meter needed to serve each customer. The EDA fee will be paid by all new water, reclaimed and sewer customers and shall be included in the connection fee.

Fire SDF - Fee


FIRE LINE FEE - \$500 per inch of diameter for connection of private fire hydrants and sprinkler system lines to the City's lines.

TEMPORARY FIRE HYDRANT - There is a \$1,000 deposit and a \$500 setup fee; monthly service fees apply for consumption.

TEMPORARY/SEASONAL SERVICE - There is a \$25.00 disconnect fee and a \$25 reconnection fee; minimum service fees apply.

Harlinsdale
 Concession / Restroom
 Facility: \$24,995.00/
 (1") one inch meter.

bjs.0

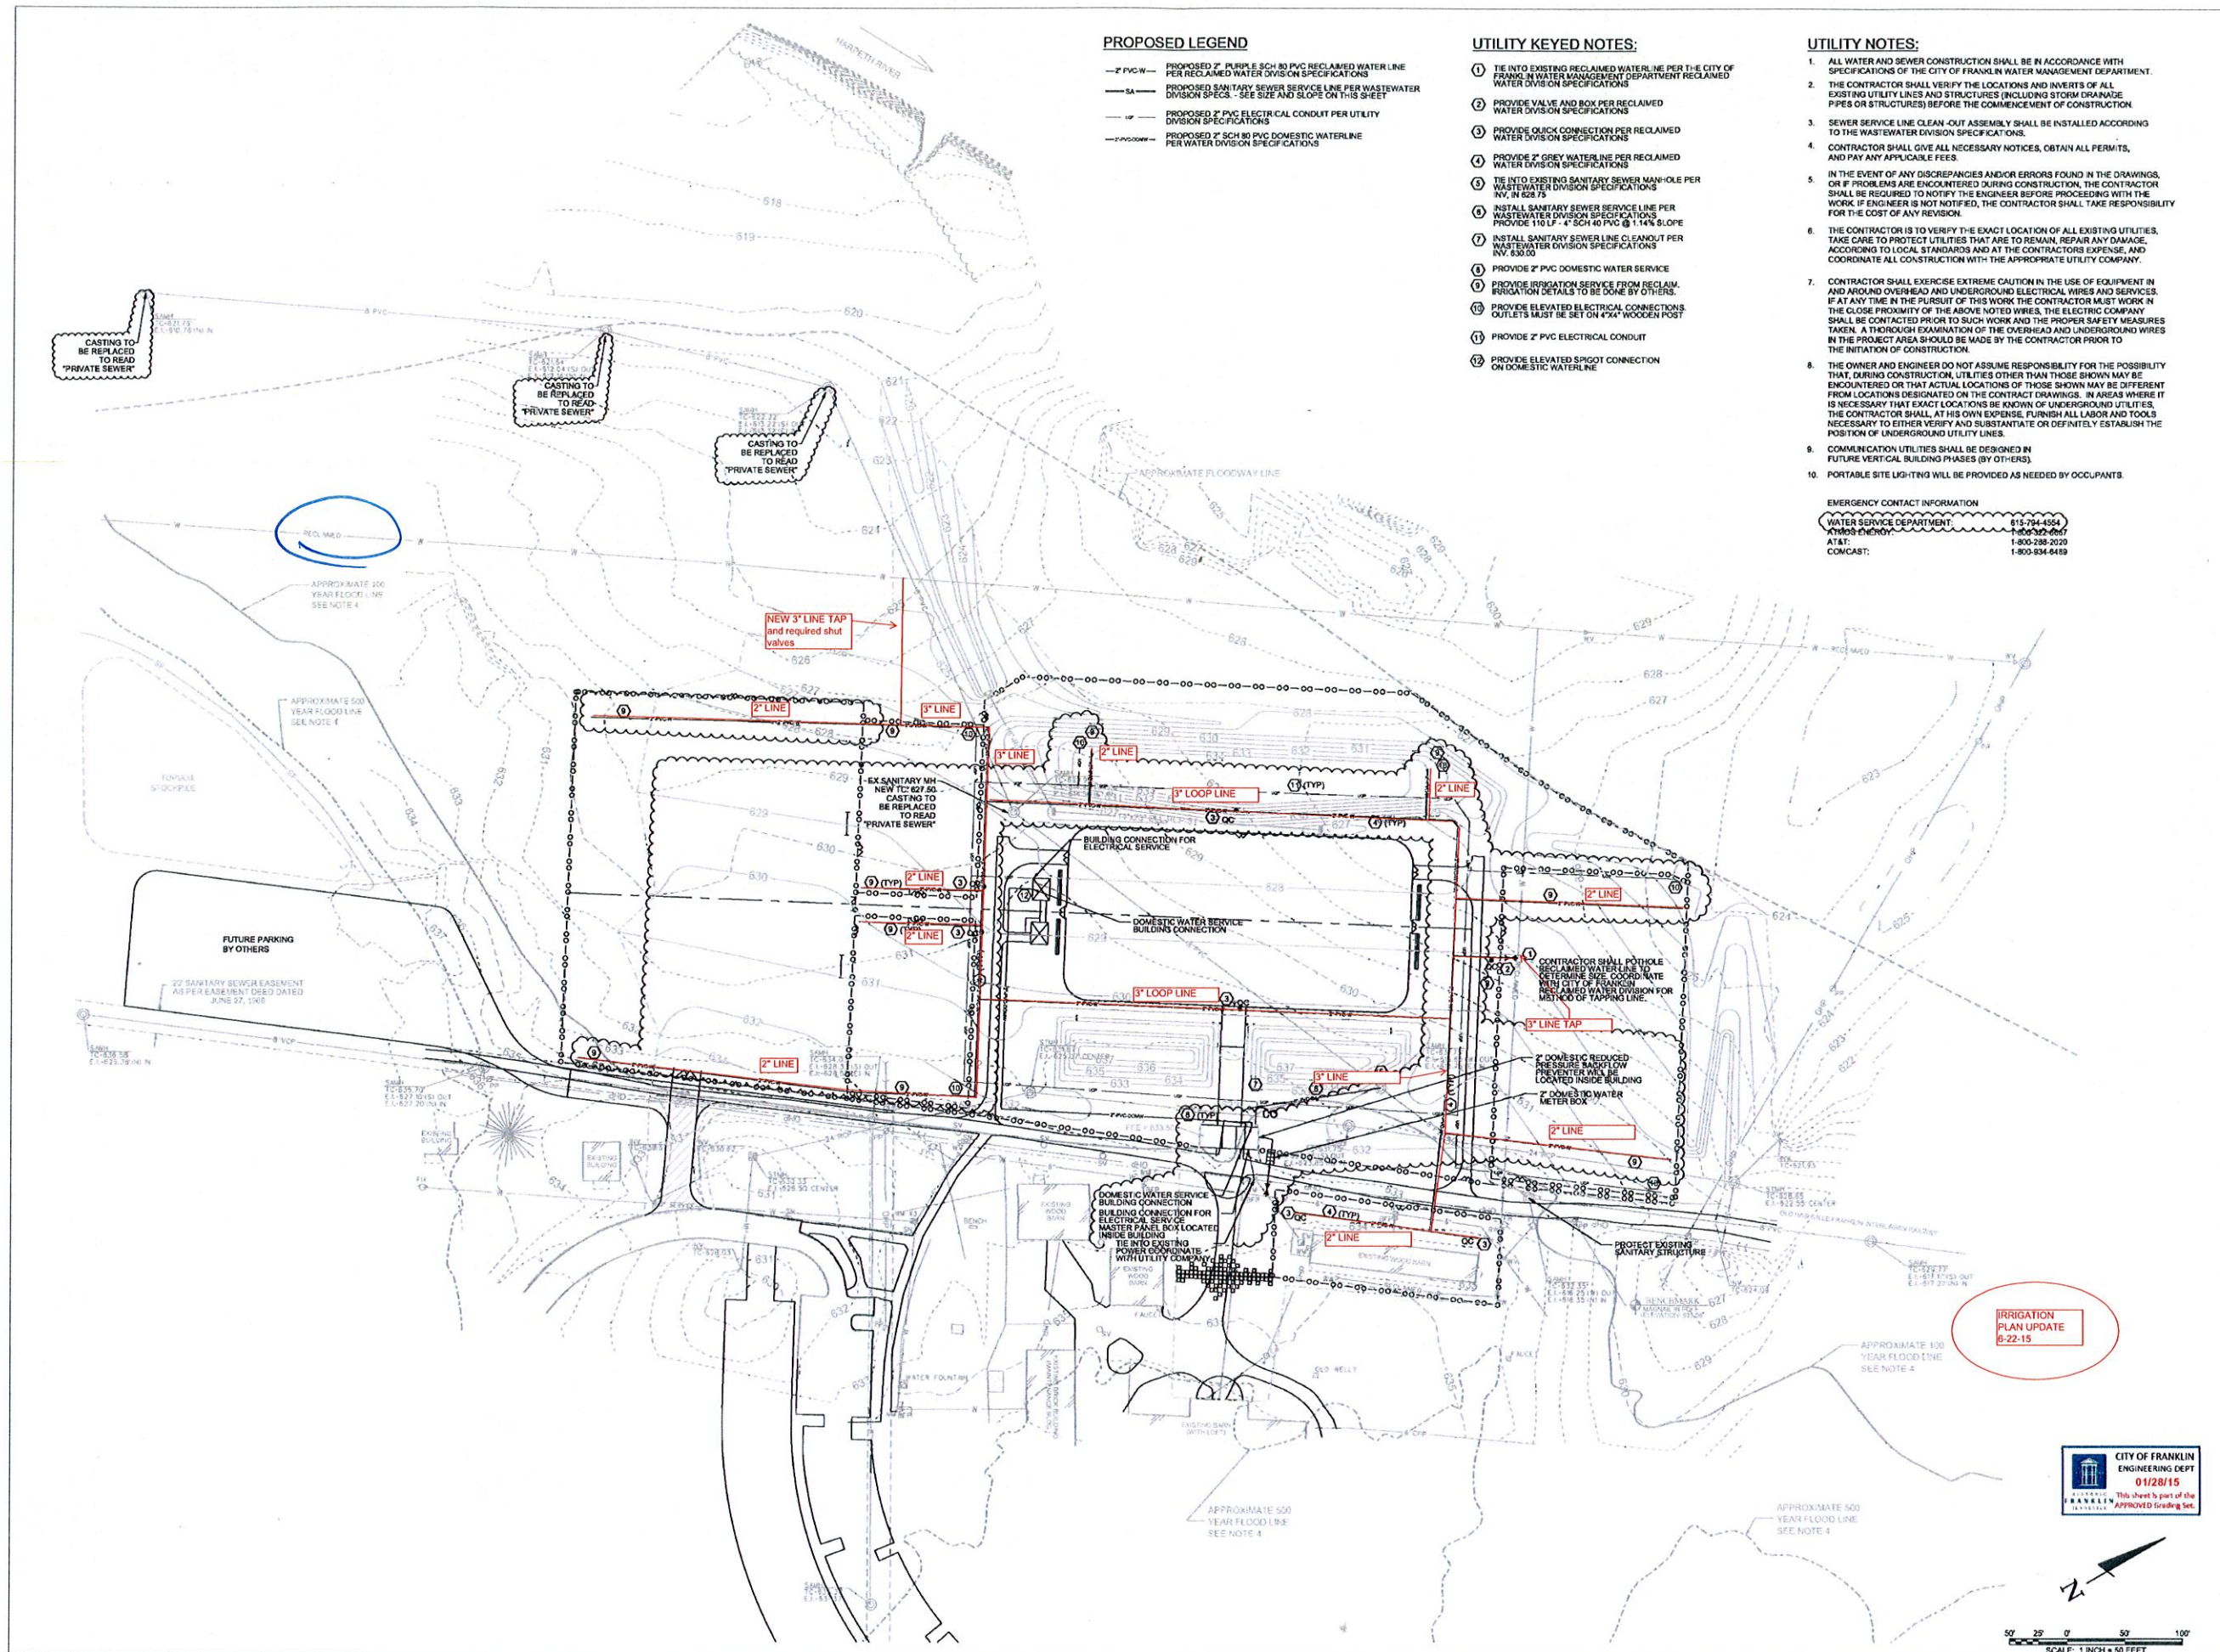

PROPOSED LEGEND

- 2" PVC W - PROPOSED 2" PURP. E. SCH 80 PVC RECLAIMED WATER LINE PER RECLAIMED WATER DIVISION SPECIFICATIONS
- SA - PROPOSED SANITARY SEWER SERVICE LINE PER WASTEWATER DIVISION SPECS. - SEE SIZE AND SLOPE ON THIS SHEET
- 2" PVC - PROPOSED 2" PVC ELECTRICAL CONDUIT PER UTILITY DIVISION SPECIFICATIONS
- 2" PVC DOM - PROPOSED 2" SCH 80 PVC DOMESTIC WATERLINE PER WATER DIVISION SPECIFICATIONS

UTILITY KEYED NOTES:

1. TIE INTO EXISTING RECLAIMED WATERLINE PER THE CITY OF FRANKLIN WATER MANAGEMENT DEPARTMENT RECLAIMED WATER DIVISION SPECIFICATIONS
2. PROVIDE VALVE AND BOX PER RECLAIMED WATER DIVISION SPECIFICATIONS
3. PROVIDE QUICK CONNECTION PER RECLAIMED WATER DIVISION SPECIFICATIONS
4. PROVIDE 2" GREY WATERLINE PER RECLAIMED WATER DIVISION SPECIFICATIONS
5. TIE INTO EXISTING SANITARY SEWER MAN-HOLE PER WASTEWATER DIVISION SPECIFICATIONS
6. INSTALL SANITARY SEWER SERVICE LINE PER WASTEWATER DIVISION SPECIFICATIONS PROVIDE 110 LF - 4" SCH 40 PVC @ 1.14% SLOPE
7. INSTALL SANITARY SEWER LINE CLEANOUT PER WASTEWATER DIVISION SPECIFICATIONS INV. 530.00
8. PROVIDE 2" PVC DOMESTIC WATER SERVICE
9. PROVIDE IRRIGATION SERVICE FROM RECLAIM. IRRIGATION DETAILS TO BE DONE BY OTHERS.
10. PROVIDE ELEVATED ELECTRICAL CONNECTIONS. OUTLETS MUST BE SET ON 4"x4" WOODEN POST
11. PROVIDE 2" PVC ELECTRICAL CONDUIT
12. PROVIDE ELEVATED SPIGOT CONNECTION ON DOMESTIC WATERLINE

UTILITY NOTES:

1. ALL WATER AND SEWER CONSTRUCTION SHALL BE IN ACCORDANCE WITH SPECIFICATIONS OF THE CITY OF FRANKLIN WATER MANAGEMENT DEPARTMENT.
2. THE CONTRACTOR SHALL VERIFY THE LOCATIONS AND INVERTS OF ALL EXISTING UTILITY LINES AND STRUCTURES (INCLUDING STORM DRAINAGE PIPES OR STRUCTURES) BEFORE THE COMMENCEMENT OF CONSTRUCTION.
3. SEWER SERVICE LINE CLEAN-OUT ASSEMBLY SHALL BE INSTALLED ACCORDING TO THE WASTEWATER DIVISION SPECIFICATIONS.
4. CONTRACTOR SHALL GIVE ALL NECESSARY NOTICES, OBTAIN ALL PERMITS, AND PAY ANY APPLICABLE FEES.
5. IN THE EVENT OF ANY DISCREPANCIES AND/OR ERRORS FOUND IN THE DRAWINGS, OR IF PROBLEMS ARE ENCOUNTERED DURING CONSTRUCTION, THE CONTRACTOR SHALL BE REQUIRED TO NOTIFY THE ENGINEER BEFORE PROCEEDING WITH THE WORK. IF ENGINEER IS NOT NOTIFIED, THE CONTRACTOR SHALL TAKE RESPONSIBILITY FOR THE COST OF ANY REVISION.
6. THE CONTRACTOR IS TO VERIFY THE EXACT LOCATION OF ALL EXISTING UTILITIES. TAKE CARE TO PROTECT UTILITIES THAT ARE TO REMAIN, REPAIR ANY DAMAGE, ACCORDING TO LOCAL STANDARDS AND AT THE CONTRACTORS EXPENSE, AND COORDINATE ALL CONSTRUCTION WITH THE APPROPRIATE UTILITY COMPANY.
7. CONTRACTOR SHALL EXERCISE EXTREME CAUTION IN THE USE OF EQUIPMENT IN AND AROUND OVERHEAD AND UNDERGROUND ELECTRICAL WIRES AND SERVICES. IF AT ANY TIME IN THE PURSUIT OF THIS WORK THE CONTRACTOR MUST WORK IN THE CLOSE PROXIMITY OF THE ABOVE NOTED WIRES, THE ELECTRIC COMPANY SHALL BE CONTACTED PRIOR TO SUCH WORK AND THE PROPER SAFETY MEASURES TAKEN. A THOROUGH EXAMINATION OF THE OVERHEAD AND UNDERGROUND WIRES IN THE PROJECT AREA SHOULD BE MADE BY THE CONTRACTOR PRIOR TO THE INITIATION OF CONSTRUCTION.
8. THE OWNER AND ENGINEER DO NOT ASSUME RESPONSIBILITY FOR THE POSSIBILITY THAT, DURING CONSTRUCTION, UTILITIES OTHER THAN THOSE SHOWN MAY BE ENCOUNTERED OR THAT ACTUAL LOCATIONS OF THOSE SHOWN MAY BE DIFFERENT FROM LOCATIONS DESIGNATED ON THE CONTRACT DRAWINGS. IN AREAS WHERE IT IS NECESSARY THAT EXACT LOCATIONS BE KNOWN OF UNDERGROUND UTILITIES, THE CONTRACTOR SHALL, AT HIS OWN EXPENSE, FURNISH ALL LABOR AND TOOLS NECESSARY TO EITHER VERIFY AND SUBSTANTIATE OR DEFINITELY ESTABLISH THE POSITION OF UNDERGROUND UTILITY LINES.
9. COMMUNICATION UTILITIES SHALL BE DESIGNED IN FUTURE VERTICAL BUILDING PHASES BY OTHERS.
10. PORTABLE SITE LIGHTING WILL BE PROVIDED AS NEEDED BY OCCUPANTS.

EMERGENCY CONTACT INFORMATION
 WATER SERVICE DEPARTMENT: 615-794-4554
 AT&T: 1-800-288-9020
 COMCAST: 1-800-834-6419

KISERVOGRINDESIGN
 5005 Meridian Blvd. Ste 100
 Franklin, TN 37067
 615.620.7171

BWSC HISTORICAL CONCEPTS
 MULTIMEDIA/URBAN PLANNING



HARLINSDALE FARM SITE PLAN
MULTI-PURPOSE EQUESTRIAN CENTER
 FRIENDS OF FRANKLIN PARKS, FRANKLIN, WILLIAMSON COUNTY, TENNESSEE
SITE UTILITY PLAN

CDF PROJECT # 4896
 DESIGNED BY JAW
 CHECKED BY RSH
 DATE: 01/28/15
 REVISIONS: 13:14 PER CITY COMMENTS
 14:06:08 13:14 PER CITY COMMENTS
 PROJECT # 1582.00



DATE: 04/08/2014
 SHEET NUMBER
C3.01

